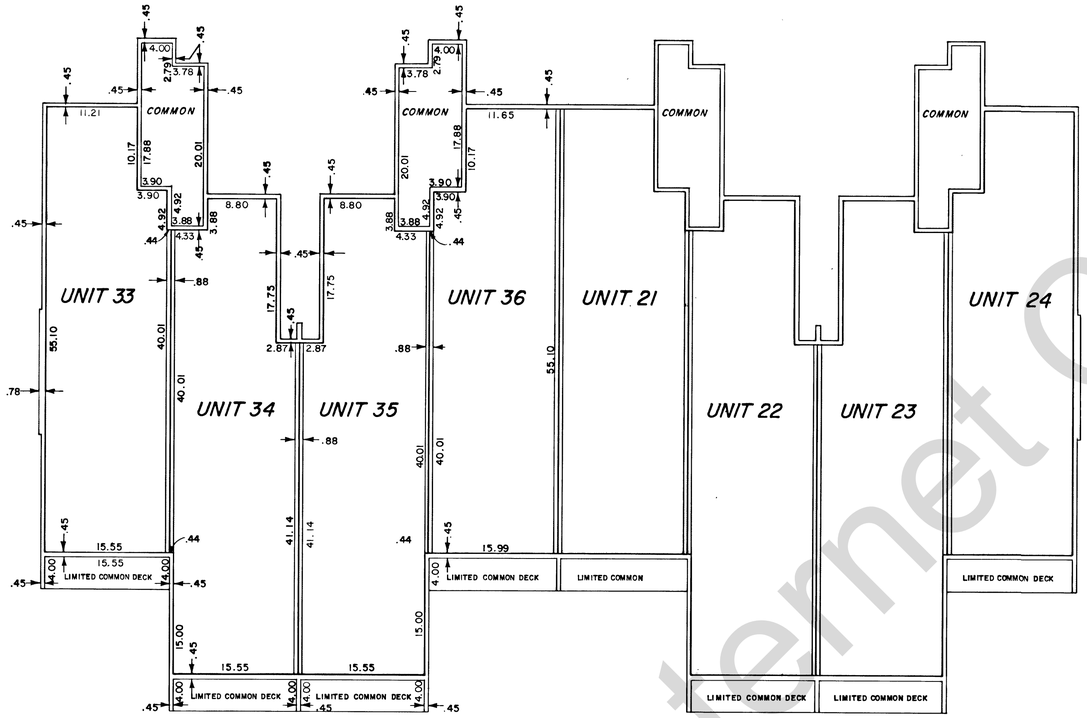

BUILDING "A" THIRD FLOOR PLAN

SCALE 1" = 10'

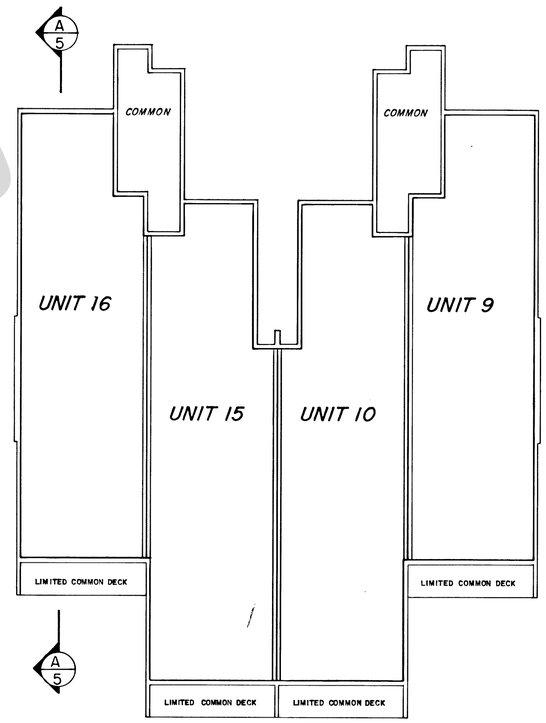

BUILDING "B" THIRD FLOOR PLAN

SCALE 1" = 10'

NOTE:
DIMENSIONS SHOWN ARE TYPICAL FOR ALL RESPECTIVE UNITS.

SHEET 4 OF 5

FIRST AMENDED RECORD OF SURVEY MAP OF

SWEETWATER BEAR LAKE CONDOSHARE PROJECT III
RICH COUNTY, UTAH

AAA ENGINEERING & DRAFTING, INC.
SALT LAKE CITY, UTAH

~~RECORDED NO.~~ _____

~~STATE OF UTAH, COUNTY OF RICH, RECORDED AT~~
~~THE REQUEST OF~~ _____

~~DATE~~ _____ ~~TIME~~ _____ ~~BOOK~~ _____ ~~PAGE~~ _____

~~FEE~~ _____ _____
~~COUNTY RECORDER~~

Internet Copy